
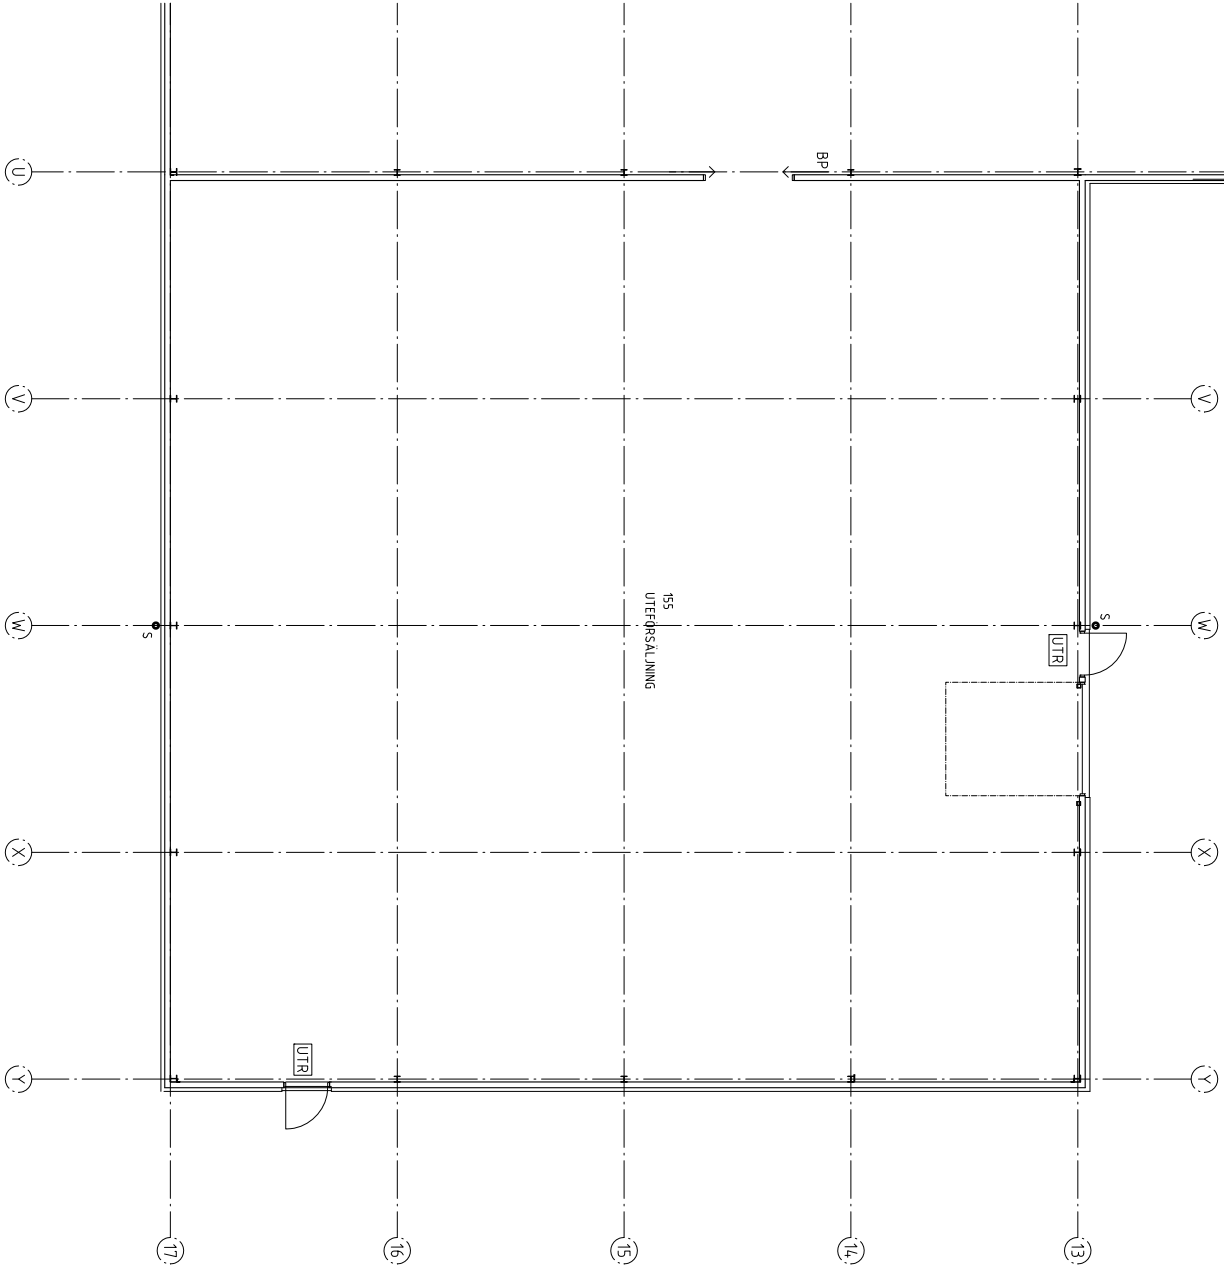


BET	ANT	ANBUDSOMÅN	SKÖN	DATUM
RELATIONSHANDLING				
1	4	1	1	1
2	1	1	1	1
3	1	1	1	1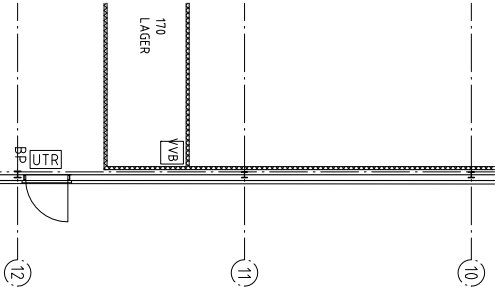
NYBYGGNAD AV BUTIK
GOLVLÄGGAREN 3, VÄRNAMO KOMMUN

A	A+F ARKITEKTKONTOR	TEL 08-3333108
M/K	BSY/ARKITEKTER SÄNGENJÖDER AB	FAX 08-3333143
V	VVS-TEKNIK	TEL 08-716133
R	VVS KONSTRUKTIONER	TEL 08-716133
E	ELÅD ELMONSTRATIONER	FAX 08-31784
K	EAB	TEL 08-31784
ST	EAB	TEL 08-31784
B	FASTIGHETS AB CORALLEN	FAX 08-31784
PL	BSY/ARKITEKTER SÄNGENJÖDER AB	TEL 08-31784
UTSÄG	RIKED AV KONSTRUKTION	UTSÄG
UTSÄG	RIKED AV KONSTRUKTION	UTSÄG

DATUM 2008-09-30
ANSVARIG

MÄTTSÄTTNING, LITTRERING

PLAN 1 DELS	NUMMER	I BET
SKALA 1:100	A-40.1-105	
A3 A31200		